

MIDCO  
P.O. Box 1448  
Provo, Utah 84601

July 19, 1980

STATE OF UTAH  
Dept. of Natural Resources  
Division of Oil, Gas, & Mining  
1588 West North Temple  
Salt Lake City, Utah 84116

Atn: Mary Ann Wright

With reference to Hornet & She mines, please find inclosed the requested information in your corrispondence of June 24, 1980;


- ✓ #1- Claim map indexed on the back & color coded for identification.
- #2- The time table for backfilling, restoration, etc. There will never be more than 50 foot of trenching exposed at any one time. Main backfilling will occur within 3 days of exposure with final grading done on a weekly basis. Backfilling will also incompass surface disturbances all ready exsisting on the property. This will be done in process. Dimension of trenching aproximatly 7' deep by 20' wide. As above stated, said trenching will not exceed 50' in length at any one time.
- #3 Maximum surface disturbance in any 3-month period (7X20X50')
- #4 Stockpiling & conserving plant support material is likely unnecessary in that overburden consists of rock of varying sizes.
- #5 Vegetation coverying is sparse, and consists primairly of "Cheat grass.
- #6 The legal discription of the 2 claims is as follows.; Corner #1 of Hornet claim is S77 degrees, 34 minutes E 4801.2 feet from W $\frac{1}{4}$  Cor. Sec. 28, T12S, R18W, SLBM

Corner #1 of She #1 claim is S73 degrees 29 minutes East 3,638.4 feet from W $\frac{1}{4}$  Cor. Sec. 28, T12S, R18W, SLBM.

Hope the inclosed information is sufficient to render a speedy dicision As to the proposed mining operation.

Sincerely

Kenneth D. Westwood, agent

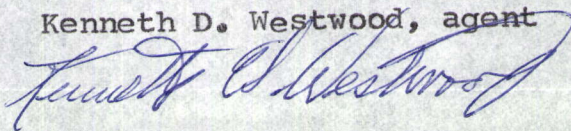

RECEIVED  
JUL 25 1980

DIVISION OF  
OIL, GAS & MINING



Handwritten marks and scribbles at the top left of the page.

Handwritten marks and scribbles at the top right of the page.

Handwritten marks and scribbles across the top of the page.

Handwritten marks and scribbles in the upper middle section of the page.


Handwritten marks and scribbles in the middle section of the page.

Handwritten marks and scribbles in the lower middle section of the page.

Handwritten marks and scribbles at the bottom left of the page.

Handwritten marks and scribbles at the bottom right of the page.

Handwritten marks and scribbles across the bottom of the page.

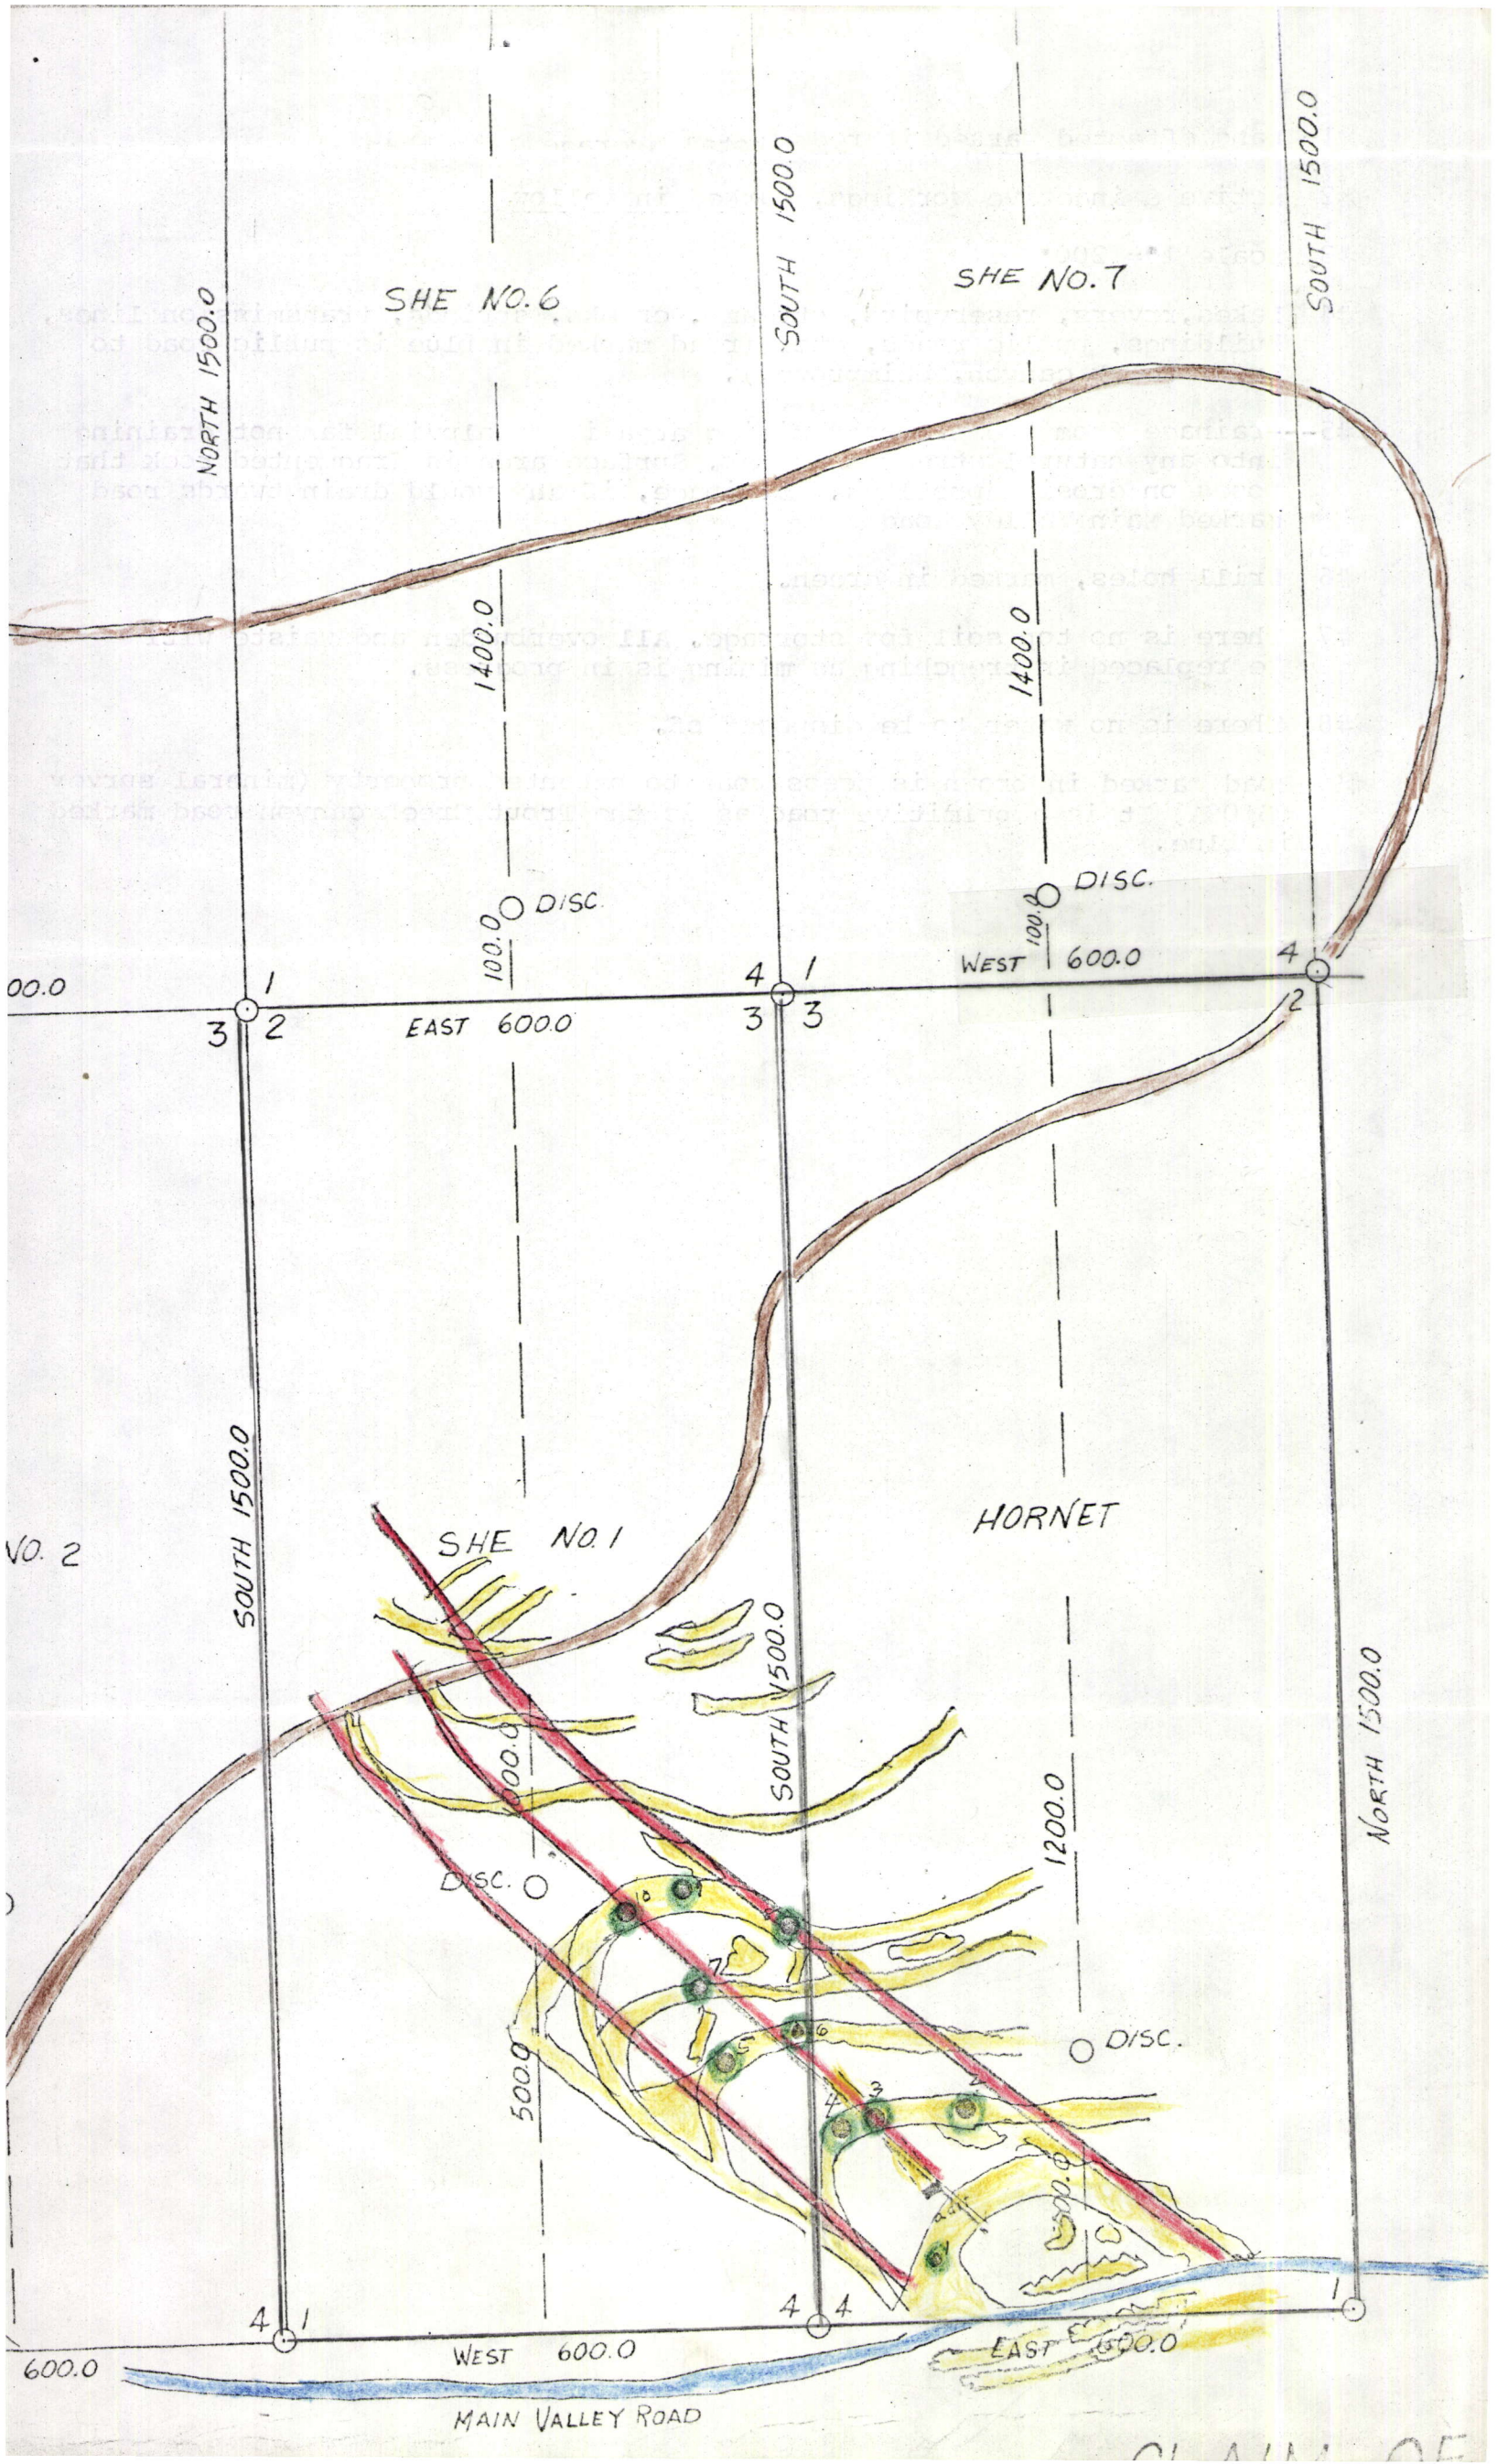



MAP

- #1- Land effected Marked in red (total acerage less than 5)
- #2 Active & inactive workings, Marked in yellow
- #3 Scale 1"= 200'
- #4 Lakes, rivers, reservoirs, streams, creeks, springs, transmission lines, buildings, public roads, etc. (road marked in blue is public road to Trout Creek canyon, unimproved).
- #5 Drainage from the proposed mining area is an aluvial fan not draining into any natural stream or creek. Surface area is fragmented rock that poses no erosion problems. Drainage, if any would drain twards road marked Main Valley Road
- #6 Drill holes, marked in green.
- ✓ #7 There is no top soil for storage. All overburden and waiste will be replaced in trenching as mining is in progress.
- #8 There is no water to be disposed of.
- #9 Road marked in brown is aces road to patented property (mineral survey #6109A) It is a primitive road as is the Trout Creek canyon road marked in blue.